

Date: Wednesday, 1/11/2006 4:30:02 PM
 User: Kim Johnston

Process Sheet

Customer : CU-DAR001 Dart Helicopters Services	Drawing Name : BEARING ASSEMBLY
Job Number : 25477	
Estimate Number : 10716	
P.O. Number : NIA	Part Number : D3121241
This Issue : 1/11/2006 S.O. No. : NIA	Drawing Number : D3121 REV C2
Prsht Rev. : NC	Project Number : N/A
First Issue : NIA Type : MACHINED PARTS	Drawing Revision : C2
Previous Run : 25297	Material : NIA
Written By : SEE COMMENT BELOW	Due Date : 1/30/2006
Checked & Approved By : SEE ABOVE DATE & USER	Qty: 19 Um: 20 Each
Comment : Est Rev:A 04.02.18 New issue KJ/DS	

Additional Product

Job Number:







Seq. #:	Machine Or Operation:	Description :
1.0	MDELNR12500	DELRIN ROUND BAR 1.25"
Comment: Qty.: 0.0431 f(s)/Unit Total : 0.8610 f(s) Material: Ø1.25 Delrin Rod (M-DELRIN-R1.2500) Identify as D3121-25 Batch: M00010		
2.0	HARDINGE	HARDINGE CNC LATHE SMALL
Comment: HARDINGE CNC LATHE SMALL 1-Turn D3121-25 Cap as per Folio FA387 2-Deburr		
3.0	QC2	INSPECT PARTS AS THEY COME OFF MACHINE
Comment: INSPECT PARTS AS THEY COME OFF MACHINE		
4.0	QC8	SECOND CHECK
Comment: SECOND CHECK		
5.0	D312123	Bearing
Comment: Qty.: 1.0000 Each(s)/Unit Total : 20.0000 Each(s) Pick: Qty Part Number Description Batch 1 D3121-23 Bearing B 25878		

Dart Aeros
 W/O:
 DATE

WORK ORDER CHANGES							
STEP	PROCEDURE CHANGE	By	Date	Qty	Approval Chief Eng / Prod Mgr	Approval QC Inspector	

Part No: _____ PAR #: _____ Fault Category: _____ NCR: Yes ☒ No ☐ DQA: ☒ Date: 06/02/20
 QA: N/C Closed: _____ Date: _____

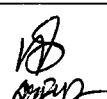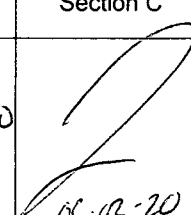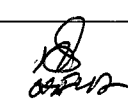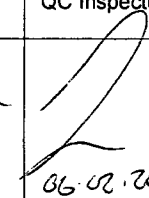NCR:		WORK ORDER NON-CONFORMANCE (NCR)						
DATE	STEP	Description of NC Section A	Corrective Action Section B			Verification Section C	Approval Chief Eng	Approval QC Inspector
			Initial Chief Eng	Action Description Chief Eng	Sign & Date			
06/02/20	6	1 D 3121-25 was scrap		Scrap + destroy	SP 06/02/20	 06.02.20		 06.02.20

NOTE: Date & initial all entries

Date: Wednesday, 1/11/2006 4:30:02 PM
User: Kim Johnston

Process Sheet

Customer: CU-DAR001 Dart Helicopters Services

Drawing Name: BEARING ASSEMBLY

Job Number: 25477

Part Number: D3121241

Job Number:



Seq. #:

Machine Or Operation:

Description :

6.0

SMALL FAB 1

SMALL & MEDIUM FAB RESOURCE 1



Comment: SMALL & MEDIUM FAB RESOURCE 1

1-Press D3121-23 Bearing into D3121-25 Cap as per Dwg D3121

SB 06/02/20

P70

19

7.0

QC5

INSPECT WORK TO CURRENT STEP



Comment: INSPECT WORK TO CURRENT STEP

06/02/20

19

8.0

PACKAGING 1

PACKAGING RESOURCE #1



Comment: PACKAGING RESOURCE #1

Identify and Stock

Location: _____

57409

06/02/21 (19)

9.0

DC

DOCUMENT CONTROL



Comment: DOCUMENT CONTROL

Inspection Level 21

5415 06/02/22

(19)

(19) 06/02/22

Job Completion



W/O:		WORK ORDER CHANGES					
DATE	STEP	PROCEDURE CHANGE	By	Date	Qty	Approval Chief Eng / Prod Mgr	Approval QC Inspector

Part No: _____ PAR #: _____ Fault Category: _____ NCR: Yes No DQA: _____ Date: _____

QA: N/C Closed: _____ Date: _____


NCR:		WORK ORDER NON-CONFORMANCE (NCR)						
DATE	STEP	Description of NC Section A	Corrective Action Section B			Verification Section C	Approval Chief Eng	Approval QC Inspector
			Initial Chief Eng	Action Description Chief Eng	Sign & Date			

NOTE: Date & initial all entries



DESIGN #	DRAWN BY CP	DART AEROSPACE LTD HAWKESBURY, ONTARIO, CANADA	
CHECKED #	APPROVED #	DRAWING NO. D3121	REV. C SHEET 1 OF 10
DATE 04.02.17		TITLE BRACKET ASSEMBLY	SCALE 1:2
A	02.04.15	NEW ISSUE	
B	03.01.16	ADD RIDGES; ADD MAT'L PROP; FIX P/N ADD -141/-143/-144/-145/-146	
C	04.02.17	ADD CLEARANCE; USE -241 BEARING	
C1	CP# 04.03.26	3.97 WAS 4.00; 6.11 WAS 6.14	
C2	# 04.04.26	0.230 WAS 0.238	


RELEASED
04-03-01

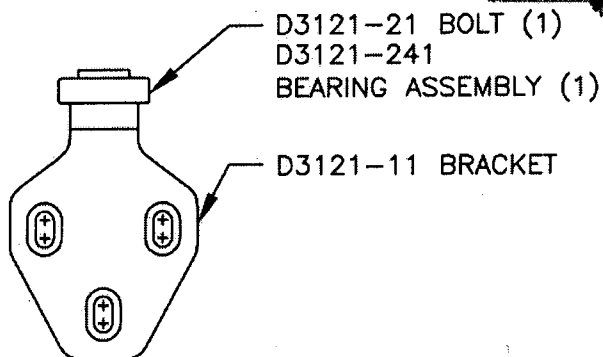

D3121-21 BOLT (1)
D3121-241
BEARING ASSEMBLY (1)

D3121-11 BRACKET


D3121-041 BRACKET ASSEMBLY
(REPLACES PREMIER P/N B30-23000-33)

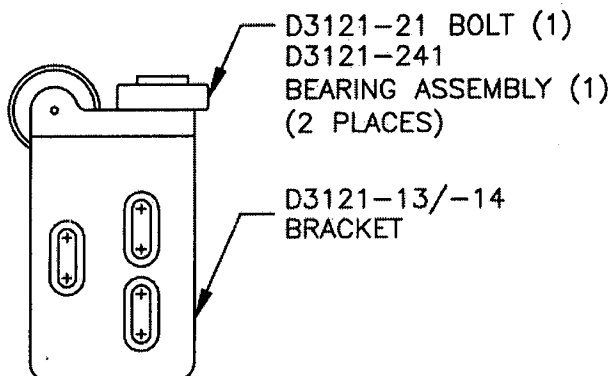

D3121-21 BOLT (1)
D3121-241
BEARING ASSEMBLY (1)
(2 PLACES)

D3121-13/-14
BRACKET

**D3121-043 (SHOWN) / D3121-044 (OPPOSITE)
BRACKET ASSEMBLY**
(REPLACES PREMIER P/N B30-23000-37/-38)

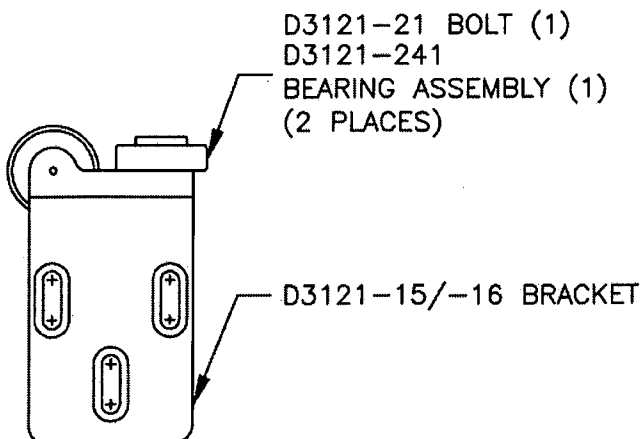

D3121-21 BOLT (1)
D3121-241
BEARING ASSEMBLY (1)
(2 PLACES)

D3121-15/-16 BRACKET

**D3121-045 (SHOWN) / D3121-046 (OPPOSITE)
BRACKET ASSEMBLY**
(REPLACES PREMIER P/N B30-23000-35/-36)

SHOWN
RETURN TO
CONFIDENTIAL
SUBJECT TO
WITHOUT


WORK ON
NO 25477

Copyright © 2002 by DART AEROSPACE LTD

THIS DOCUMENT IS PRIVATE AND CONFIDENTIAL AND IS SUPPLIED ON THE EXPRESS CONDITION THAT IT IS NOT TO BE USED FOR ANY PURPOSE OR COPIED OR COMMUNICATED TO ANY OTHER PERSON WITHOUT WRITTEN PERMISSION FROM DART AEROSPACE LTD.




DESIGN #	DRAWN BY #	DART AEROSPACE LTD HAWKESBURY, ONTARIO, CANADA	
CHECKED #	APPROVED #	DRAWING NO. D3121	REV. C SHEET 2 OF 10
DATE 04.02.17		TITLE BRACKET ASSEMBLY	SCALE 1:2

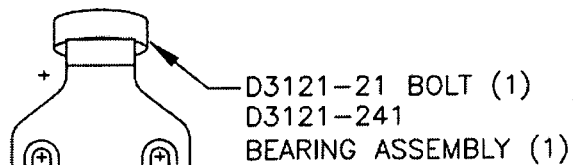

D3121-141 BRACKET ASSEMBLY
(REPLACES PREMIER P/N B30-23001-01)


D3121-111 BRACKET

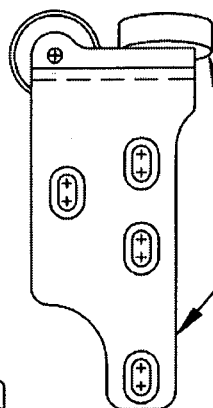

D3121-21 BOLT (1)
D3121-241 BEARING ASSEMBLY (1)
(2 PLACES)

D3121-113/-114 BRACKET

D3121-143 (SHOWN) / D3121-144 (OPPOSITE)
BRACKET ASSEMBLY
(REPLACES PREMIER P/N B30-23000-03/-04)

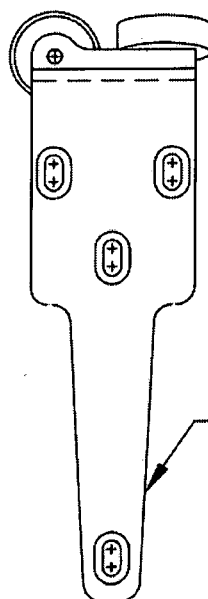

D3121-21 BOLT (1)
D3121-241 BEARING ASSEMBLY (1)
(2 PLACES)

D3121-115/-116
BRACKET

D3121-145 (SHOWN) / D3121-146 (OPPOSITE)
BRACKET ASSEMBLY
(REPLACES PREMIER P/N B30-23000-05/-06)

OBJECT TO AMENDMENT
WITHOUT NOTICE

WORK ORDER
NO. 25477

RELEASED
04.03.01

Copyright © 2002 by DART AEROSPACE LTD



THIS DOCUMENT IS PRIVATE AND CONFIDENTIAL AND IS SUPPLIED ON THE EXPRESS CONDITION THAT IT IS NOT TO BE USED FOR ANY PURPOSE OR COPIED OR COMMUNICATED TO ANY OTHER PERSON WITHOUT WRITTEN PERMISSION FROM DART AEROSPACE LTD.



DESIGN [Signature]	DRAWN BY [Signature]	DART AEROSPACE LTD HAWKESBURY, ONTARIO, CANADA	
CHECKED [Signature]	APPROVED [Signature]	DRAWING NO. D3121	REV. C SHEET 3 OF 10
DATE 04.02.17		TITLE BRACKET ASSEMBLY	SCALE 1:1


RELEASED
04.03.01 [Signature]

DETAIL A:
SLOT DETAIL
SCALE 2:1
VIEW ROTATED

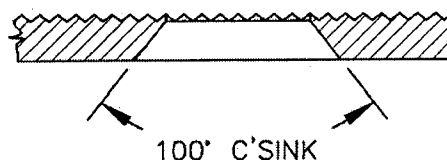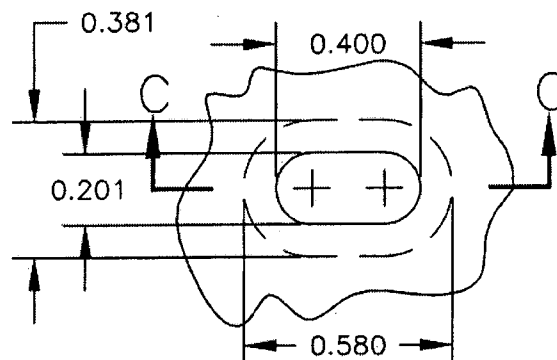

SECTION
C-C

DETAIL B:
RIDGE DETAIL
PARTIAL SECTION
SCALE 1:20

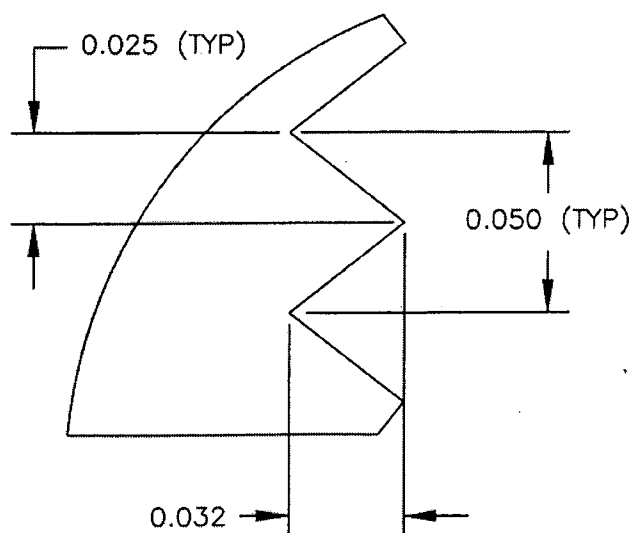

CONTROLLED COPY
SUBJECT TO AMENDMENT
WITHOUT NOTICE


WORK ORDER
NO. 25477

Copyright © 2002 by DART AEROSPACE LTD

THIS DOCUMENT IS PRIVATE AND CONFIDENTIAL AND IS SUPPLIED ON THE EXPRESS CONDITION THAT IT IS NOT TO BE USED FOR ANY PURPOSE OR COPIED OR COMMUNICATED TO ANY OTHER PERSON WITHOUT WRITTEN PERMISSION FROM DART AEROSPACE LTD.



DESIGN #	DRAWN BY P	DART AEROSPACE LTD HAWKESBURY, ONTARIO, CANADA	
CHECKED #	APPROVED #	DRAWING NO. D3121	REV. C SHEET 5 OF 10
DATE 04.02.18		TITLE BRACKET ASSEMBLY	SCALE 1:2

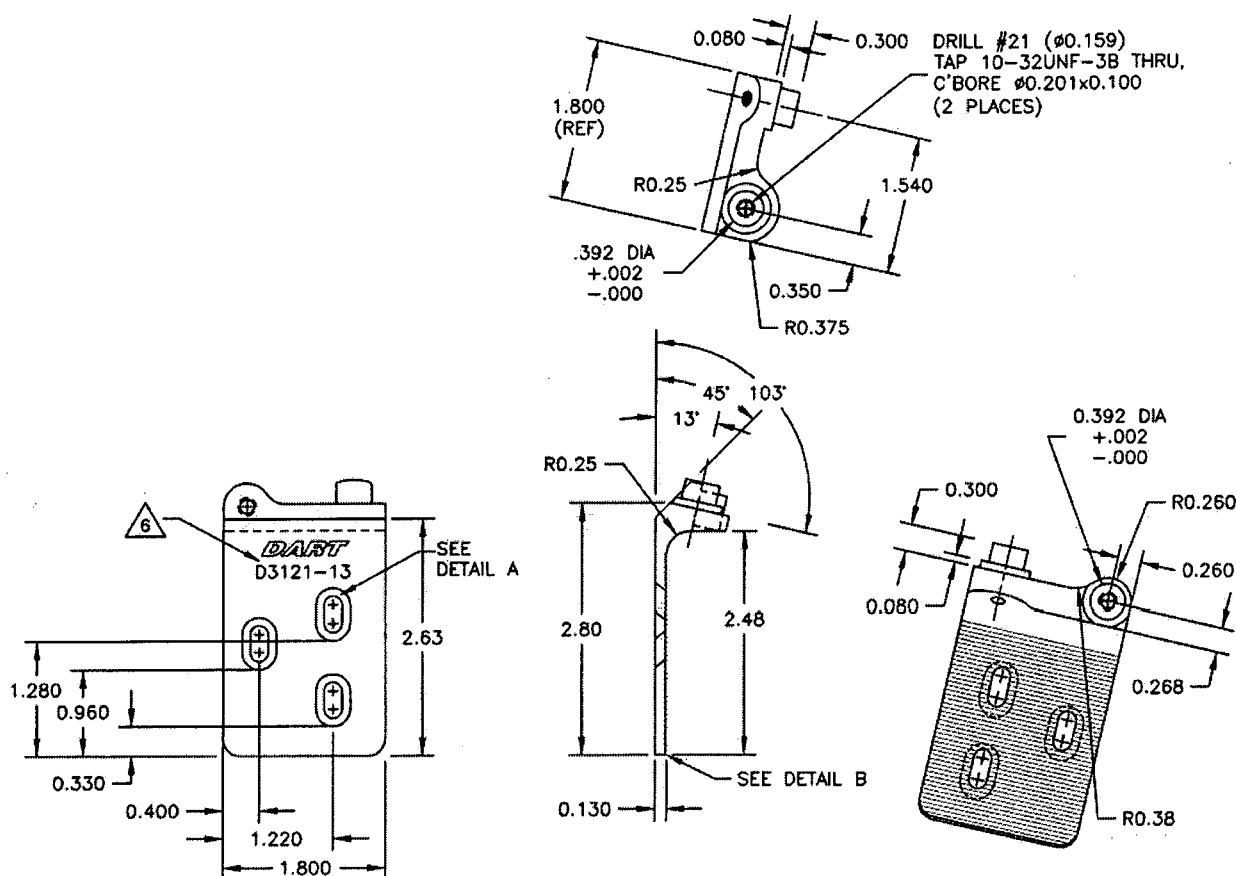

D3121-13 BRACKET (SHOWN)
D3121-14 BRACKET (OPPOSITE)

- 1) MATERIAL: 17-4 SS PER AMS 5604/5643 (REF DART SPEC. M17-4-B)
MIN ULTIMATE TENSILE STRENGTH = 150 ksi
MIN YIELD TENSILE STRENGTH = 100 ksi
- 2) TOLERANCES ARE PER DART QSI 018 UNLESS OTHERWISE NOTED
- 3) ALL DIMENSIONS ARE IN INCHES
- 4) BREAK ALL SHARP EDGES 0.005 TO 0.015
- 5) ENGRAVE DART P/N & LOGO AS SHOWN
- 6) HOLE IN SPIGOT TO BE CONCENTRIC WITHIN 0.005

SHOP COPY
RETURN TO
ENGINEERING
UNCONTROLLED COPY
SUBJECT TO AMENDMENT
WITHOUT NOTICE

WORK ORDER
NO 28477


RELEASED
04.03.01

Copyright © 2002 by DART AEROSPACE LTD

THIS DOCUMENT IS PRIVATE AND CONFIDENTIAL AND IS SUPPLIED ON THE EXPRESS CONDITION THAT IT IS NOT TO BE USED FOR ANY PURPOSE OR COPIED OR COMMUNICATED TO ANY OTHER PERSON WITHOUT WRITTEN PERMISSION FROM DART AEROSPACE LTD.



DESIGN #	DRAWN BY CP	DART AEROSPACE LTD HAWKESBURY, ONTARIO, CANADA	
CHECKED #	APPROVED #	DRAWING NO. D3121	REV. C SHEET 4 OF 10
DATE 04.02.17		TITLE BRACKET ASSEMBLY	SCALE 1:1

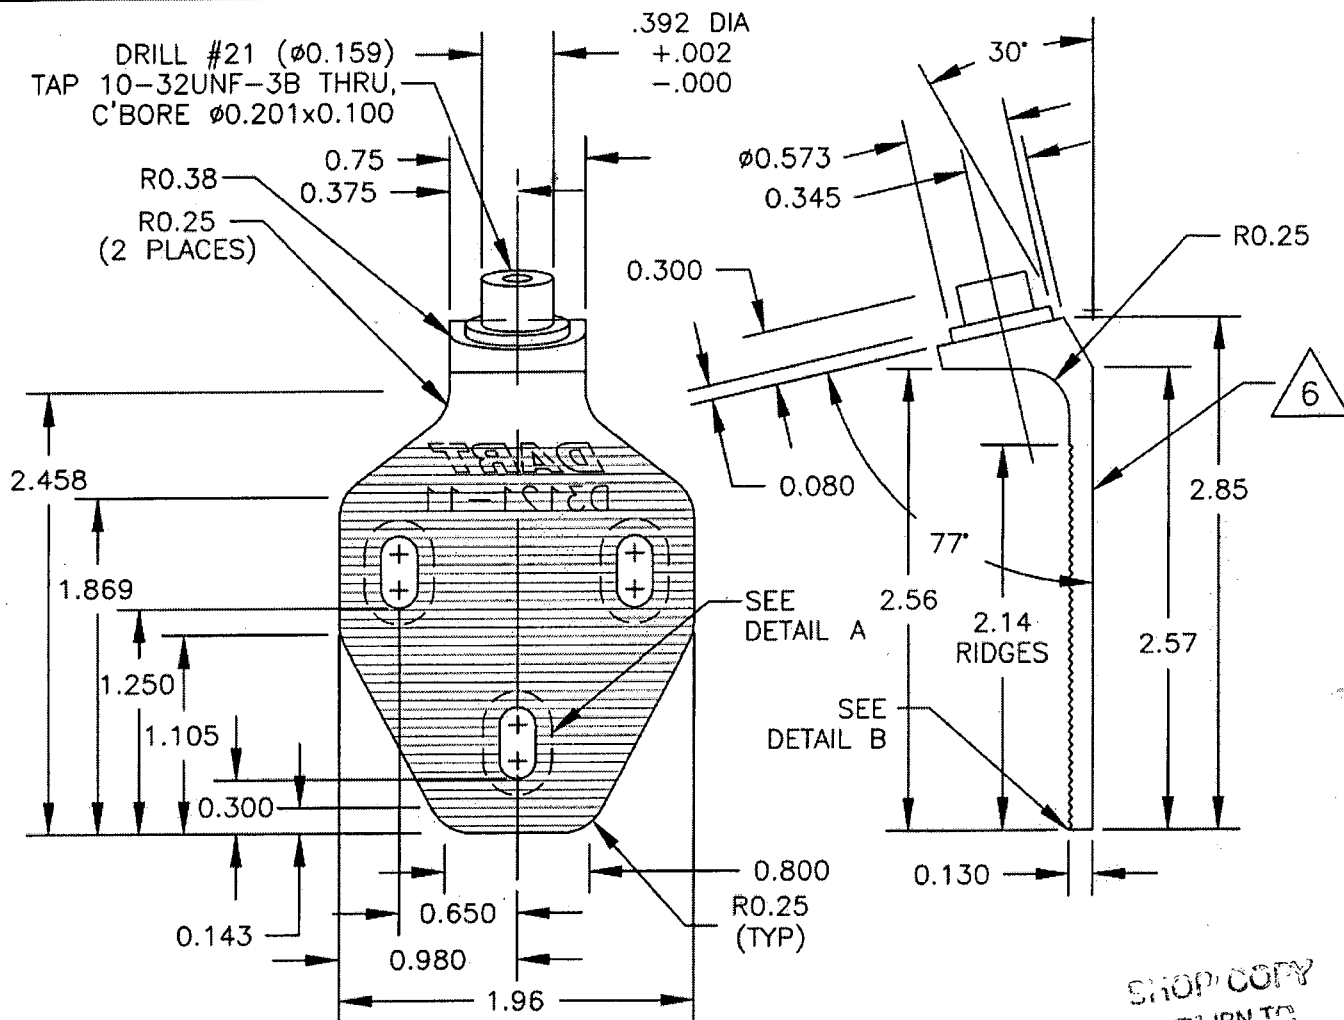

D3121-11 BRACKET

- 1) MATERIAL: 17-4 SS PER AMS 5604/5643 (REF DART SPEC. M17-4-B)
MIN ULTIMATE TENSILE = 150 ksi
MIN YIELD TENSILE = 100 ksi
- 2) TOLERANCES ARE PER DART QSI 018 UNLESS OTHERWISE NOTED
- 3) ALL DIMENSIONS ARE IN INCHES
- 4) BREAK ALL SHARP EDGES 0.005 TO 0.015
- 5) ENGRAVE DART P/N & LOGO AS SHOWN
- 6) HOLE IN SPIGOT TO BE CONCENTRIC WITHIN 0.005

SHOP COPY
RETURN TO
ENGINEERING
UNCONTROLLED COPY

NO 25477


RELEASED
04.03.01

Copyright © 2004 by DART AEROSPACE LTD

THIS DOCUMENT IS PRIVATE AND CONFIDENTIAL AND IS SUPPLIED ON THE EXPRESS CONDITION THAT IT IS NOT TO BE USED FOR ANY PURPOSE OR COPIED OR COMMUNICATED TO ANY OTHER PERSON WITHOUT WRITTEN PERMISSION FROM DART AEROSPACE LTD.

DART

DESIGN #	DRAWN BY UP	DART AEROSPACE LTD HAWKESBURY, ONTARIO, CANADA	
CHECKED #	APPROVED #	DRAWING NO. D3121	REV. C SHEET 6 OF 10
DATE 04.02.18		TITLE BRACKET ASSEMBLY	SCALE 1:2

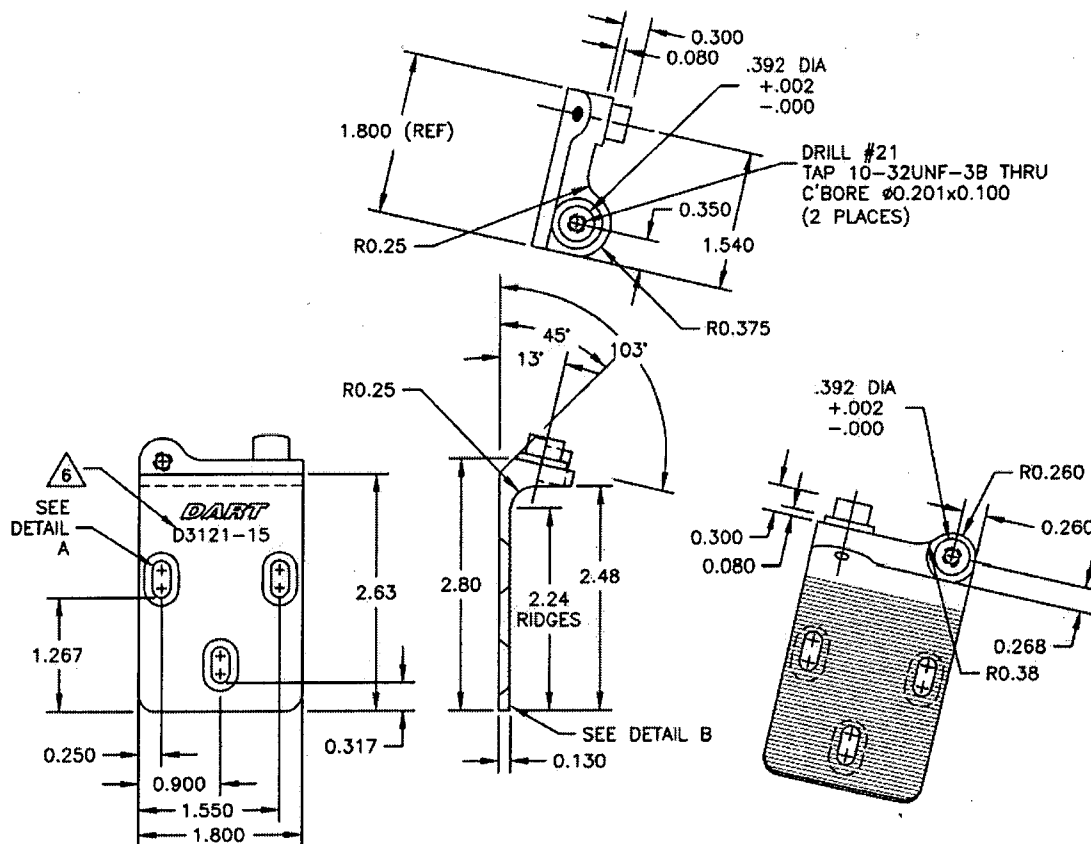**D3121-15 BRACKET (SHOWN)****D3121-16 BRACKET (OPPOSITE)**

- 1) MATERIAL: 17-4 SS PER AMS 5604/5643 (REF DART SPEC. M17-4-B)
MIN ULTIMATE TENSILE = 150 ksi
MIN YIELD TENSILE = 100 ksi
- 2) TOLERANCES ARE PER DART QSI 018 UNLESS OTHERWISE NOTED
- 3) ALL DIMENSIONS ARE IN INCHES
- 4) BREAK ALL SHARP EDGES 0.005 TO 0.015
- 5) ENGRAVE DART P/N AND LOGO AS SHOWN
- 6) HOLE IN SPIGOT TO BE CONCENTRIC WITHIN 0.005

STOP COPY
RETURN TO
ENGINEERING
UNCONTROLLED COPY
SUBJECT TO AMENDMENT
WITHOUT NOTICE

WORK ORDER
NO 25477


RELEASED
04.03.01

Copyright © 2002 by DART AEROSPACE LTD

THIS DOCUMENT IS PRIVATE AND CONFIDENTIAL AND IS SUPPLIED ON THE EXPRESS CONDITION THAT IT IS NOT TO BE USED FOR ANY PURPOSE OR COPIED OR COMMUNICATED TO ANY OTHER PERSON WITHOUT WRITTEN PERMISSION FROM DART AEROSPACE LTD.



DESIGN #	DRAWN BY OP	DART AEROSPACE LTD HAWKESBURY, ONTARIO, CANADA	
CHECKED #	APPROVED #	DRAWING NO. D3121	REV. C SHEET 7 OF 10
DATE 04.02.18		TITLE BRACKET ASSEMBLY	SCALE 1:2

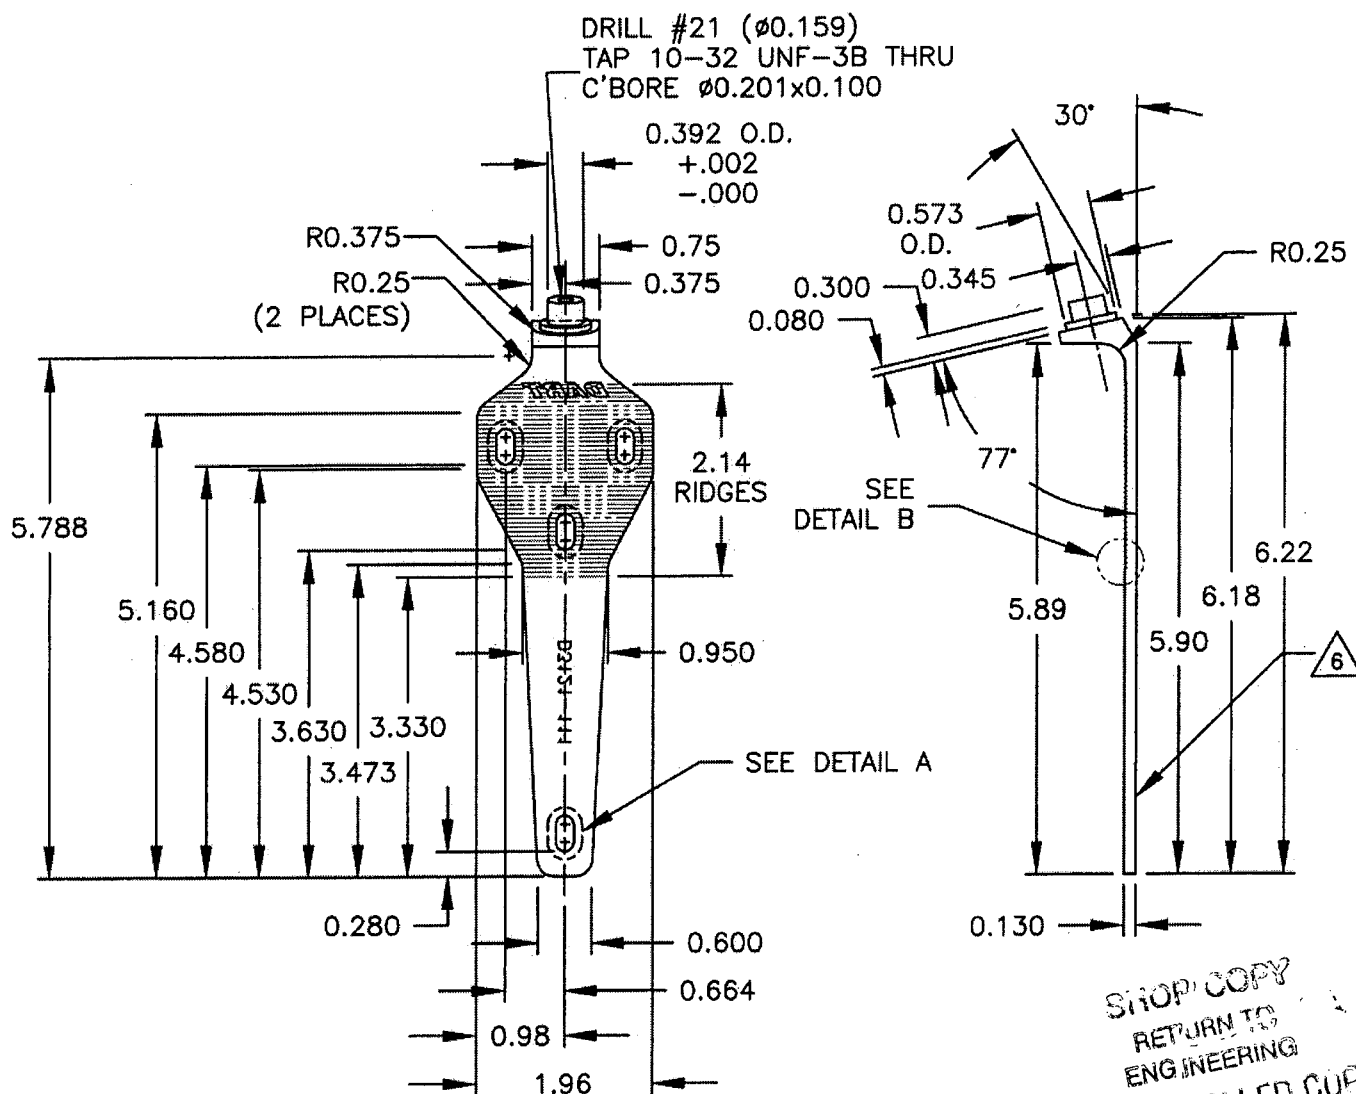

D3121-111 BRACKET

- 1) REPLACES PREMIER P/N B32-23001-11
- 2) MATERIAL: 17-4 SS PER AMS 5604/5643 (REF DART SPEC. M17-4-B)
MIN ULTIMATE TENSILE = 150 ksi
MIN YIELD TENSILE = 100 ksi
- 3) TOLERANCES ARE PER DART QSI 018 UNLESS OTHERWISE NOTED
- 4) ALL DIMENSIONS ARE IN INCHES
- 5) BREAK ALL SHARP EDGES 0.005 TO 0.015
- 6) ENGRAVE DART P/N & LOGO IN AREAS SHOWN
- 7) HOLE IN SPIGOT TO BE CONCENTRIC WITHIN 0.005

SHOP COPY
RETURN TO
ENGINEERING
UNCONTROLLED COPY
SUBJECT TO AMENDMENT
WITHOUT NOTICE


WORK ORDER
NO 25477
RELEASED
04.03.01

Copyright © 2002 by DART AEROSPACE LTD

THIS DOCUMENT IS PRIVATE AND CONFIDENTIAL AND IS SUPPLIED ON THE EXPRESS CONDITION THAT IT IS NOT TO BE USED FOR ANY PURPOSE OR COPIED OR COMMUNICATED TO ANY OTHER PERSON WITHOUT WRITTEN PERMISSION FROM DART AEROSPACE LTD.

DART

DESIGN <i>[Signature]</i>	DRAWN BY <i>[Signature]</i>	DART AEROSPACE LTD HAWKESBURY, ONTARIO, CANADA	
CHECKED <i>[Signature]</i>	APPROVED <i>[Signature]</i>	DRAWING NO. D3121	REV. C SHEET 8 OF 10
DATE 04.02.18	TITLE BRACKET ASSEMBLY		SCALE 1:2

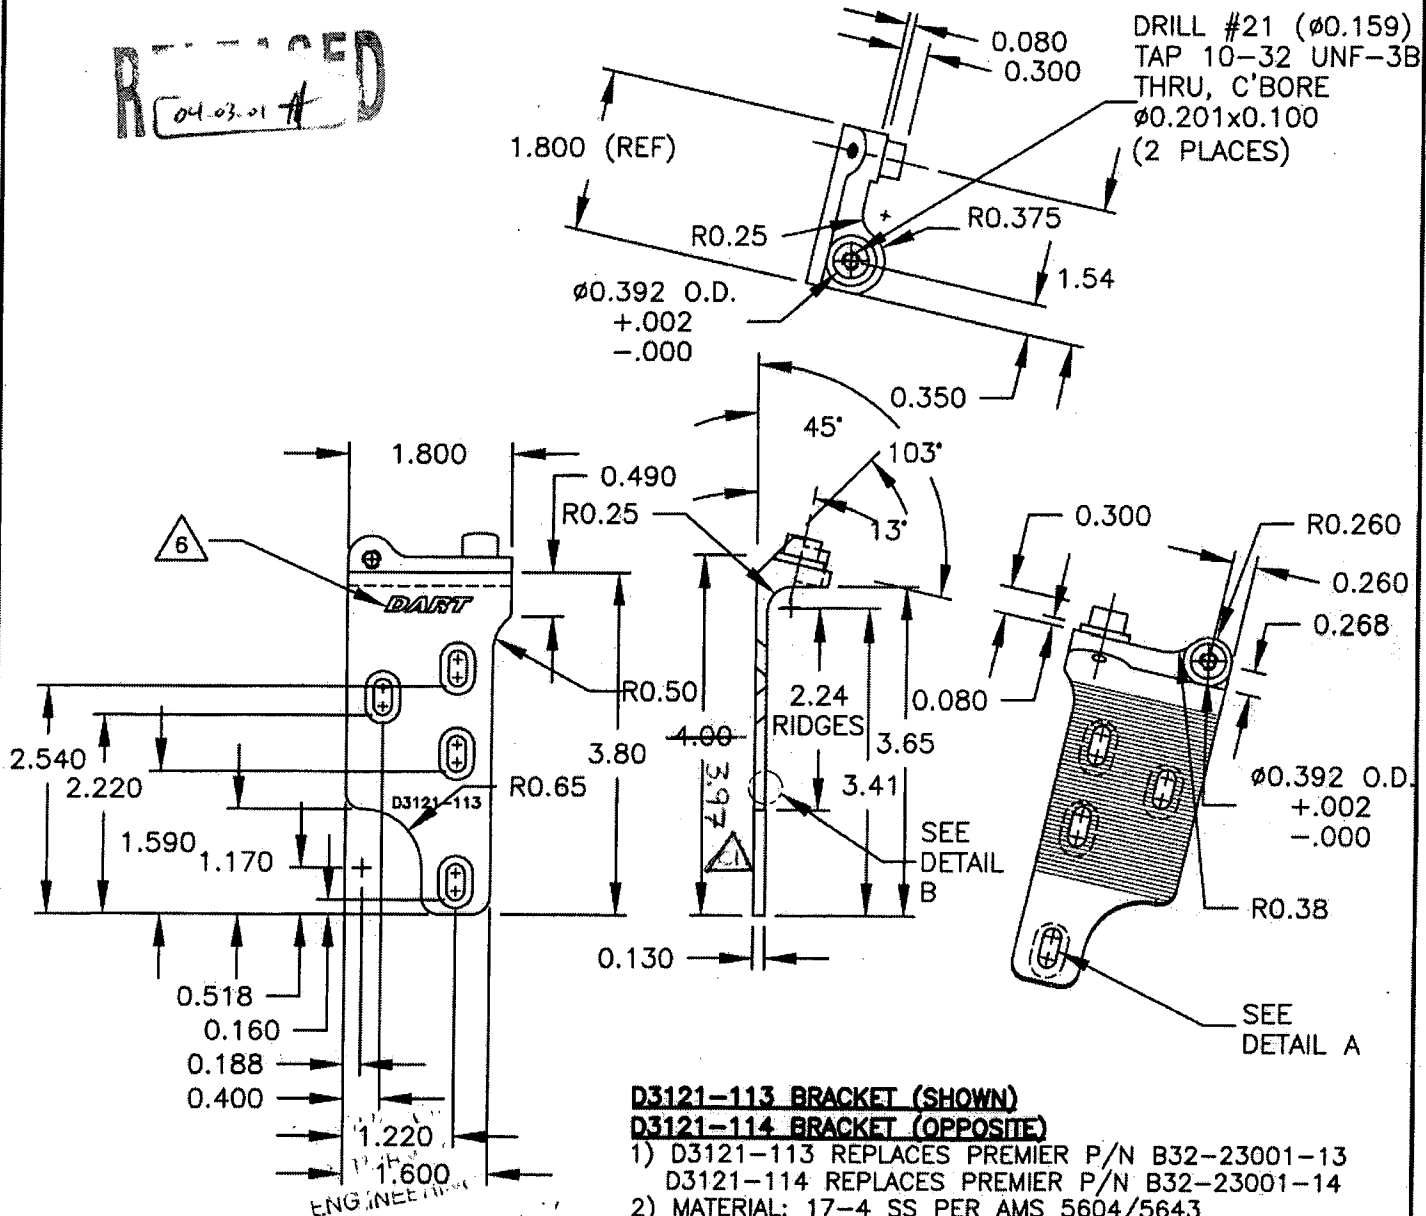REVISIONS
04.03.01 *[Signature]***D3121-113 BRACKET (SHOWN)****D3121-114 BRACKET (OPPOSITE)**

- 1) D3121-113 REPLACES PREMIER P/N B32-23001-13
D3121-114 REPLACES PREMIER P/N B32-23001-14
- 2) MATERIAL: 17-4 SS PER AMS 5604/5643
(REF DART SPEC. M17-4-B)
MIN ULTIMATE TENSILE STRENGTH = 150 ksi
MIN YIELD TENSILE STRENGTH = 100 ksi
- 3) TOLERANCES ARE PER DART QSI 018 UNLESS OTHERWISE NOTED
- 4) ALL DIMENSIONS ARE IN INCHES
- 5) BREAK ALL SHARP EDGES 0.005 TO 0.015
- 6) ENGRAVE DART P/N & LOGO IN AREAS SHOWN
- 7) HOLE IN SPIGOT TO BE CONCENTRIC WITHIN 0.005

UNCONTROLLED COPY
SUBJECT TO AMENDMENT
WITHOUT NOTICE
WORK ORDER
NO. 25477


Copyright © 2002 by DART AEROSPACE LTD

THIS DOCUMENT IS PRIVATE AND CONFIDENTIAL AND IS SUPPLIED ON THE EXPRESS CONDITION THAT IT IS NOT TO BE USED FOR ANY PURPOSE OR COPIED OR COMMUNICATED TO ANY OTHER PERSON WITHOUT WRITTEN PERMISSION FROM DART AEROSPACE LTD.

DART

DESIGN #	DRAWN BY CP	DART AEROSPACE LTD HAWKESBURY, ONTARIO, CANADA	
CHECKED #	APPROVED #	DRAWING NO. D3121	REV. C SHEET 9 OF 10
DATE 04.02.18	TITLE BRACKET ASSEMBLY		SCALE 1:2

RELEASED
04.03.01

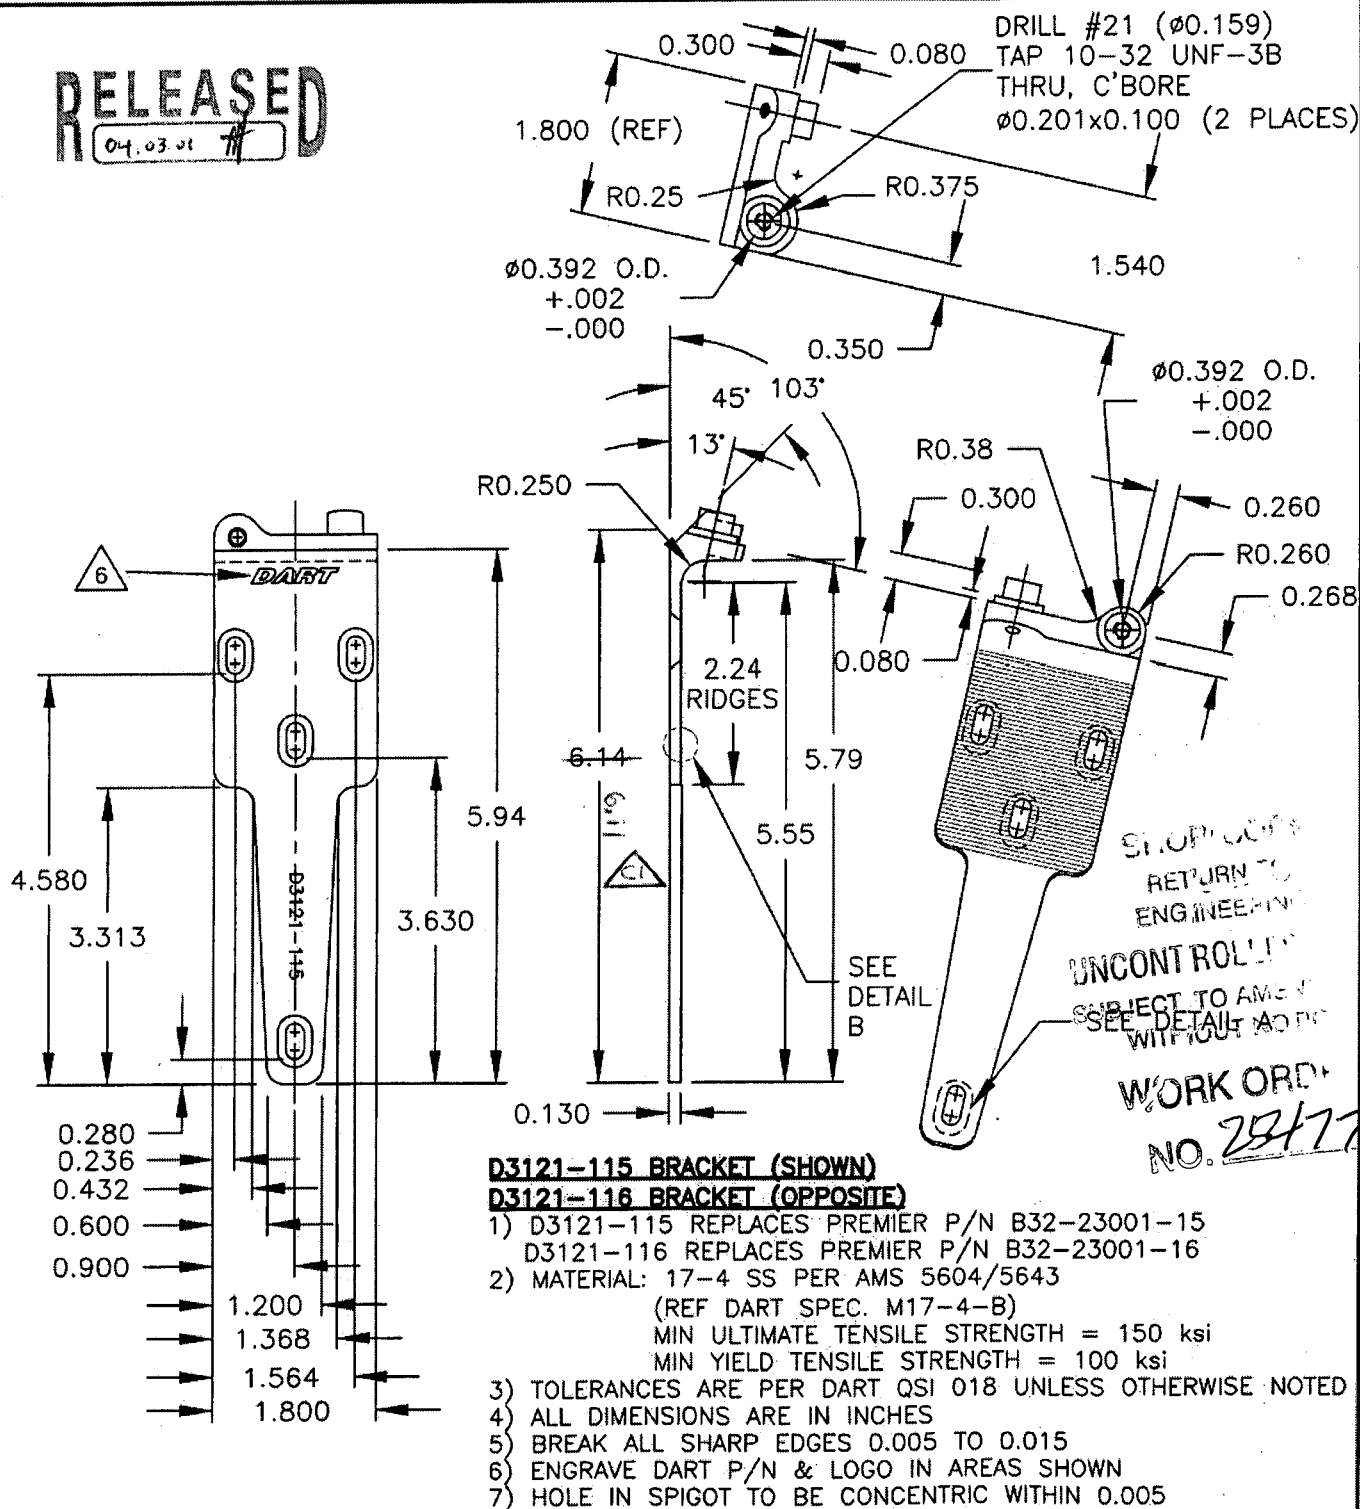


Copyright © 2002 by DART AEROSPACE LTD

THIS DOCUMENT IS PRIVATE AND CONFIDENTIAL AND IS SUPPLIED ON THE EXPRESS CONDITION THAT IT IS NOT TO BE USED FOR ANY PURPOSE OR COPIED OR COMMUNICATED TO ANY OTHER PERSON WITHOUT WRITTEN PERMISSION FROM DART AEROSPACE LTD.




DESIGN <i>[Signature]</i>	DRAWN BY <i>[Signature]</i>	DART AEROSPACE LTD HAWKESBURY, ONTARIO, CANADA	
CHECKED <i>[Signature]</i>	APPROVED <i>[Signature]</i>	DRAWING NO. D3121	REV. C SHEET 10 OF 10
DATE 04.02.17		TITLE BRACKET ASSEMBLY	SCALE 1:1

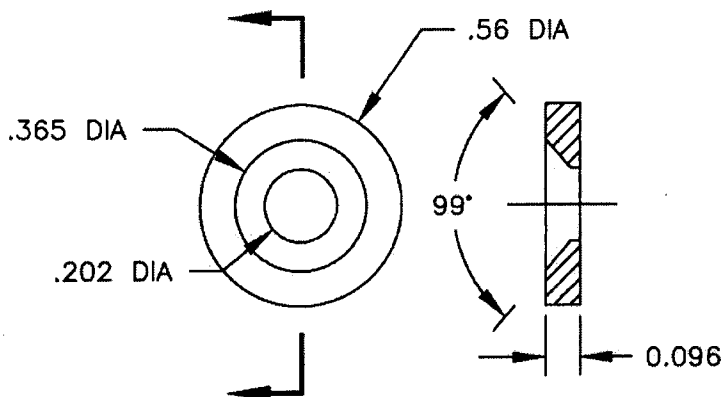


D3121-17 WASHER (SCALE 2:1)

- 1) REPLACES PREMIER P/N B32-23001-17
- 2) MATERIAL: AISI 303 SS ROUND BAR, ANNEALED (REF DART SPEC. M303R)
- 3) TOLERANCES ARE PER DART QSI 018 UNLESS OTHERWISE NOTED
- 4) ALL DIMENSIONS ARE IN INCHES
- 5) BREAK ALL SHARP EDGES 0.005 TO 0.015

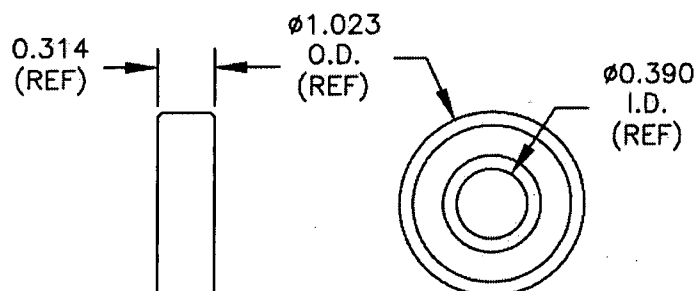


D3121-19 BEARING (SCALE 1:1)

- 1) POSSIBLE SUPPLIER: KING BEARING P/N 6000-2ZJ/EM FAFNIR P/N 9100KDD
- 2) ALL DIMENSIONS ARE IN INCHES

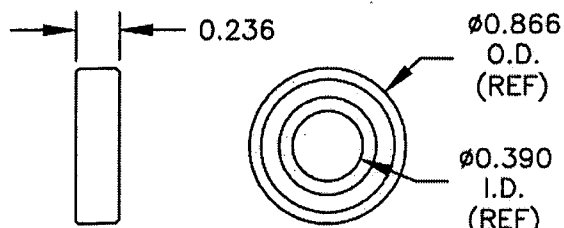


D3121-23 BEARING (SCALE 1:1)

- 1) POSSIBLE SUPPLIER: SKF P/N 61900-2Z OR KML P/N 6900-ZZ
- 2) ALL DIMENSIONS ARE IN INCHES

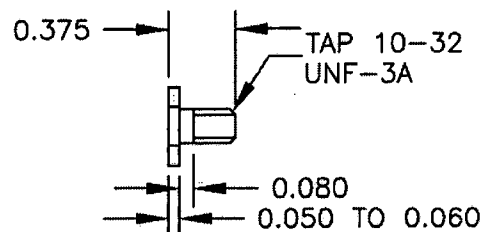

D3121-21 BOLT (SCALE 1:1)


- 1) MATERIAL: AISI 303 SS HEX, ANNEALED (REF DART SPEC. M303H0.500)
- 2) FINISH: NONE
- 3) TOLERANCES ARE PER DART QSI 018 UNLESS OTHERWISE NOTED
- 4) ALL DIMENSIONS ARE IN INCHES
- 5) BREAK ALL SHARP EDGES 0.005 TO 0.015

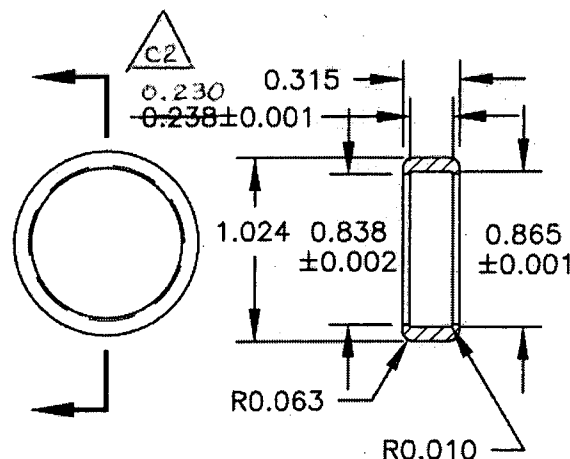

D3121-25 CAP (SCALE 1:1)

- 1) MATERIAL: DELRIN ROD, 1.25 (REF DART SPEC. M-DELRIN-R1.250)
- 2) TOLERANCES ARE PER DART QSI 018 UNLESS OTHERWISE NOTED
- 3) ALL DIMENSIONS ARE IN INCHES

RELEASED
WORK ORDER
NO. 25477

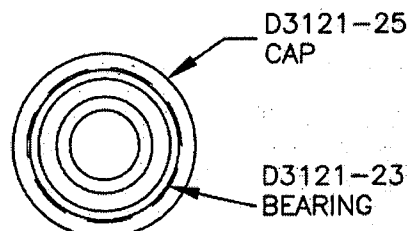

D3121-241 BEARING ASSEMBLY (SCALE 1:1)

Copyright © 2002 by DART AEROSPACE LTD

THIS DOCUMENT IS PRIVATE AND CONFIDENTIAL AND IS SUPPLIED ON THE EXPRESS CONDITION THAT IT IS NOT TO BE USED FOR ANY PURPOSE OR COPIED OR COMMUNICATED TO ANY OTHER PERSON WITHOUT WRITTEN PERMISSION FROM DART AEROSPACE LTD.

